


Minimum Lot Area
Minimum Lot Frontage
Minimum Lot Width and
MINIMUM SETBACKS
Setback From Front Property
Setback From Side Property
Setback From Rear Property
MINIMUM FLOOR AREA
Maximum Height For A
Maximum Building Coverage
Maximum Site Coverage

	A	B
INLET #1	23	43
OUTLET #2	27	37
PUMP CHAMBER #3	30	46
D-BOX #4	74	73
END #5	88	71
END #6	79	93

Eric
#1072 R
(10

N/F
Thomas Ba
#1068 Ridgiefiel
(109-24)

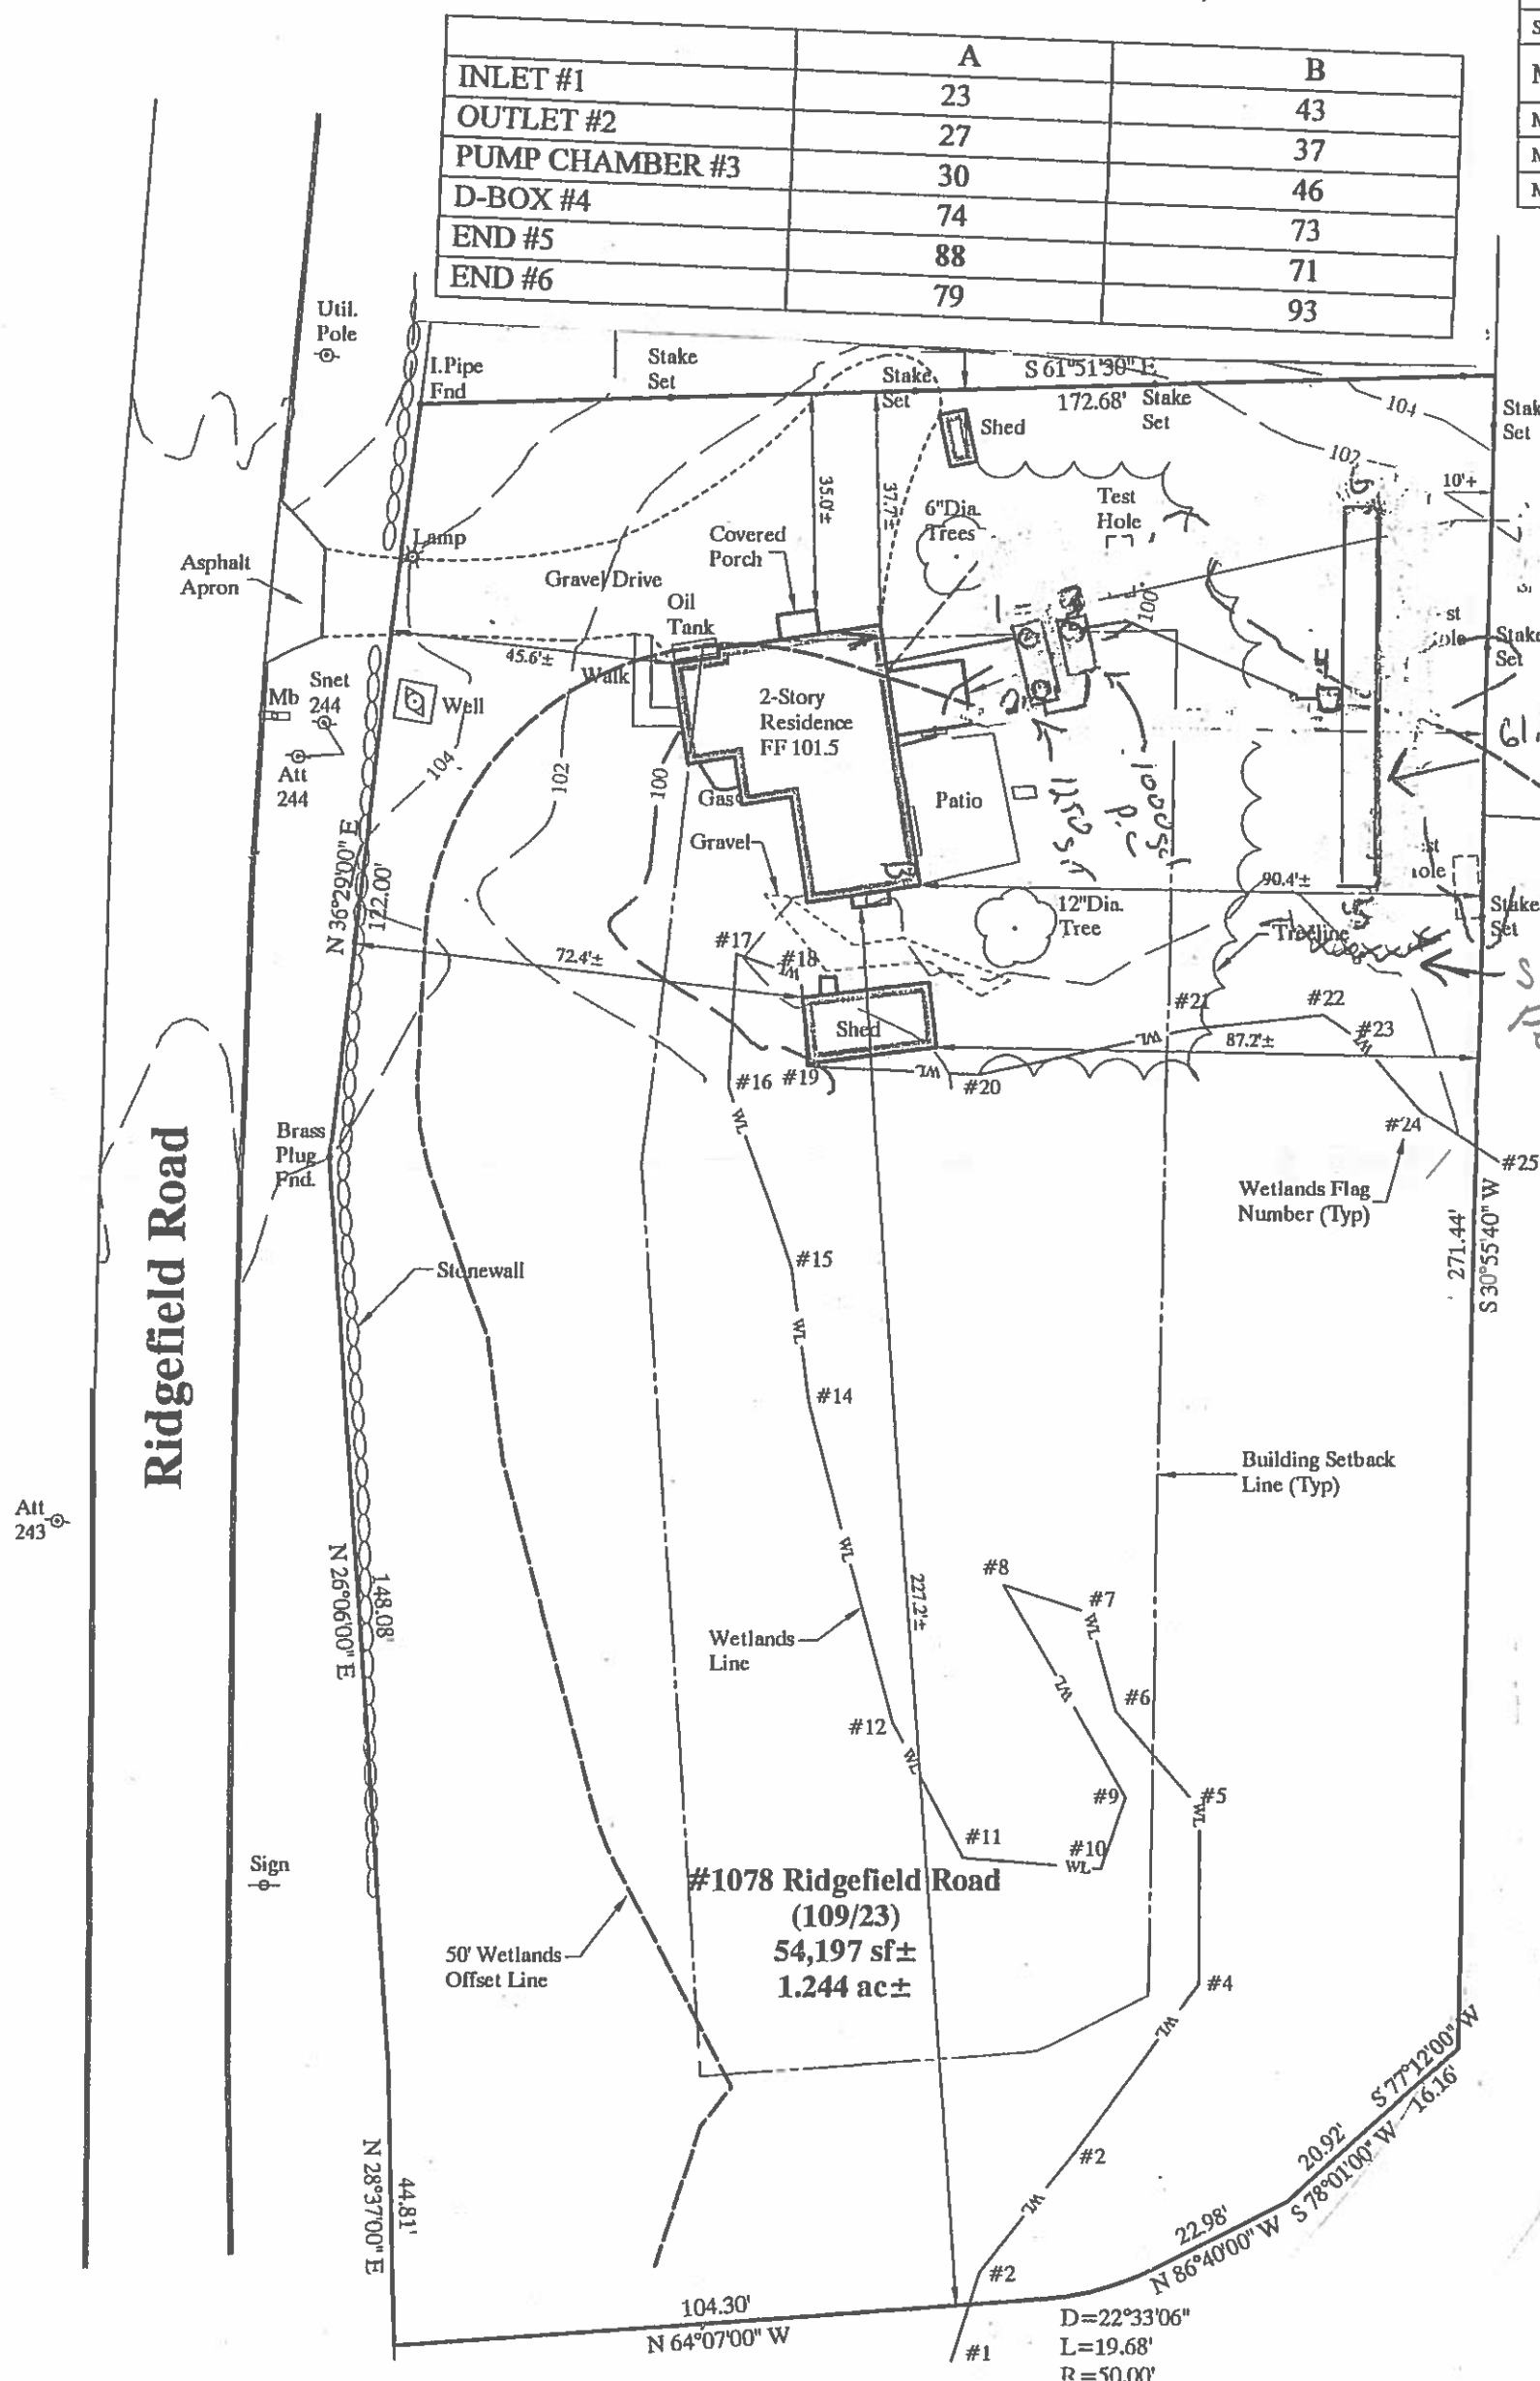

SYSTEM AS-BUILT

NOT VALID UNLESS EMBOSSED WITH SEAL OR FIXED
WITH THE LIVE STAMP OF THE SIGNATORY

TO MY KNOWLEDGE AND BELIEF, THIS MAP IS
SUBSTANTIALLY CORRECT AS NOTED HEREON

ADDRESS: 1078 RIDGEFIELD RD	TOWN: WILTON
OWNER: BIGGS	MAP: BLOCK: LOT:
DATE: 8/1/21	SCALE: 1"=30
DRAWN BY: LOUIS BIANCO	STATE LIC # 005313