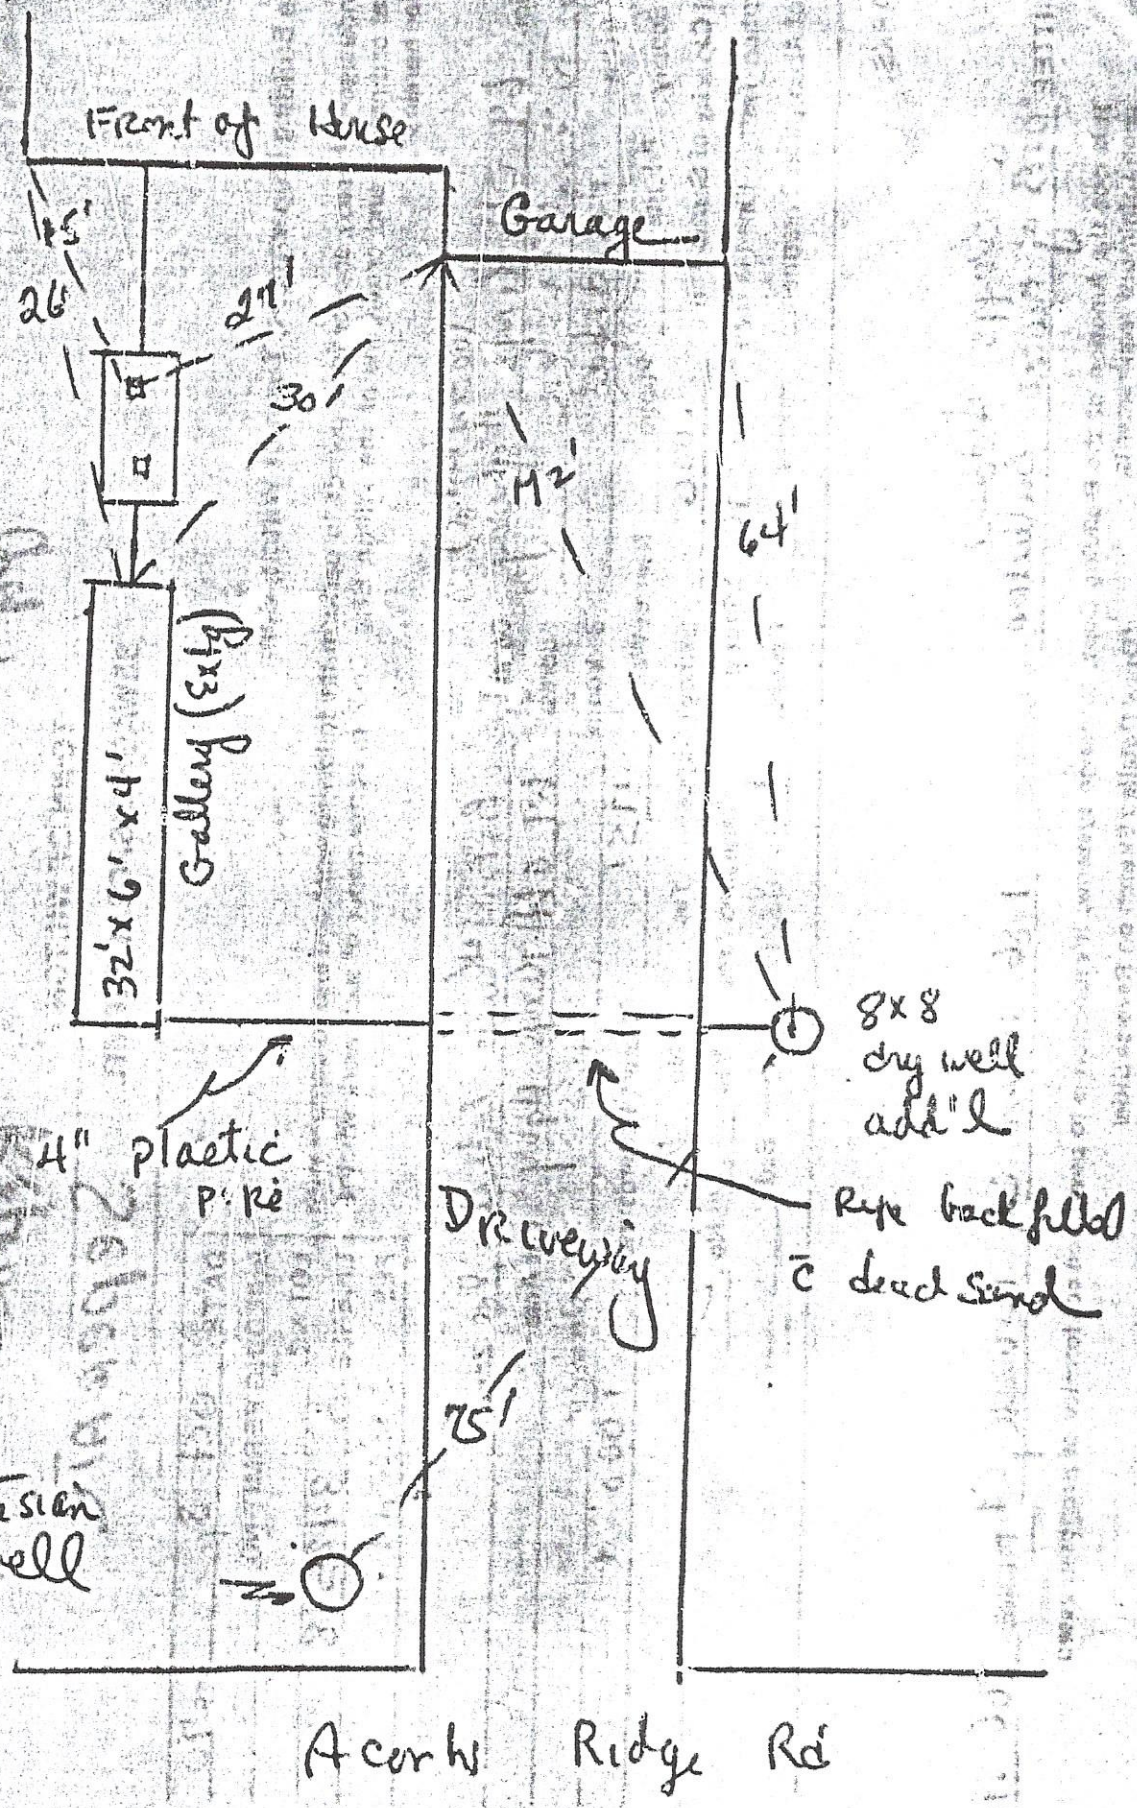
Front of House
Garage
25'
26'
21'
30'
42'
64'
32'x6'x4'
Gallery (3x4)
8x8
dry well
add'l
4" plastic
pipe
Pipe backfilled
c̄ dead sand
Driveway
75'
Artesian
well
Acorn Ridge Rd